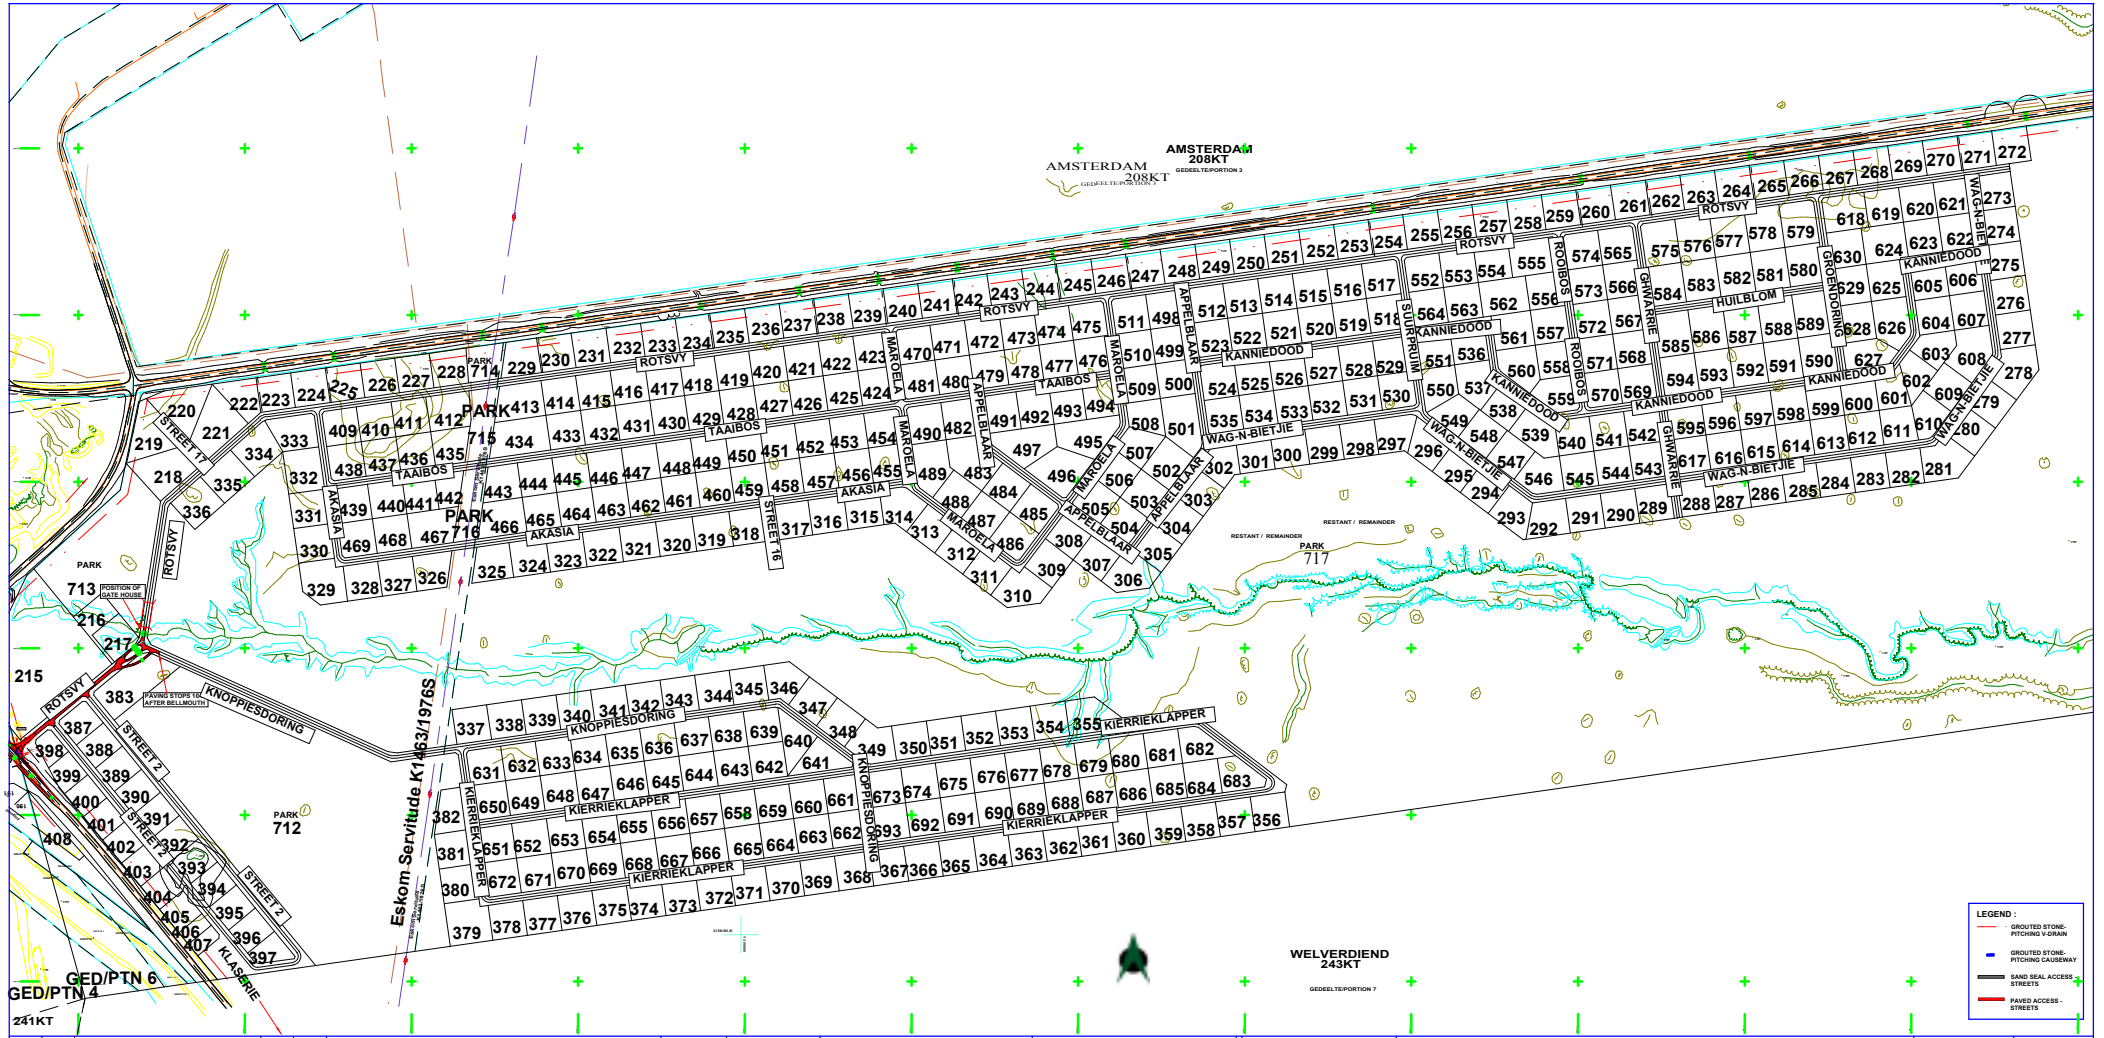

No	DATE	REVISION	CONSULT	DIR

DESIGNED BY	AB
CHECKED BY	RvdM
DRAWN BY	AB
CHECKED BY	RvdM

BOSCHPOORT ONDERNEMINGS - ENTERPRISES (Pty) Ltd
P O BOX 283
BELA BELA
0480
TEL : (014) 736 9600
FAX : (014) 736 9609

DOMBO, DU PLESSIS & PARTNERS
Professional Civil, Structural Engineers, Project Managers & Social Consultants
Professional Civil Engineers, Project Managers & Social Consultants
48 Argentina crescent
TZANEEN
0850
P O BOX 1449
TZANEEN
0850
TEL : (015) 307 7570
FAX : (015) 307 7573
e-mail@dpmsa.co.za

CEO GTM — DATE
CONSULTING ENGINEER — DATE

TS2000/92/R

HOEDSPRUIT WILDLIFE ESTATE CIVIL ENGINEERING SERVICES :
LOW INTENSITY ECO DEVELOPMENT AMSTERDAM EXT.

LAYOUT OF STREETS & STORMWATER

AS BUILT PLAN

SHEET	1 OF 2
SCALE	1 : 3 500
CONSULTANTS DRAWING NUMBER	TS2000/92/R
GTM DRAWING NUMBER	TS2000/92/R/01C